Building Floor Plans

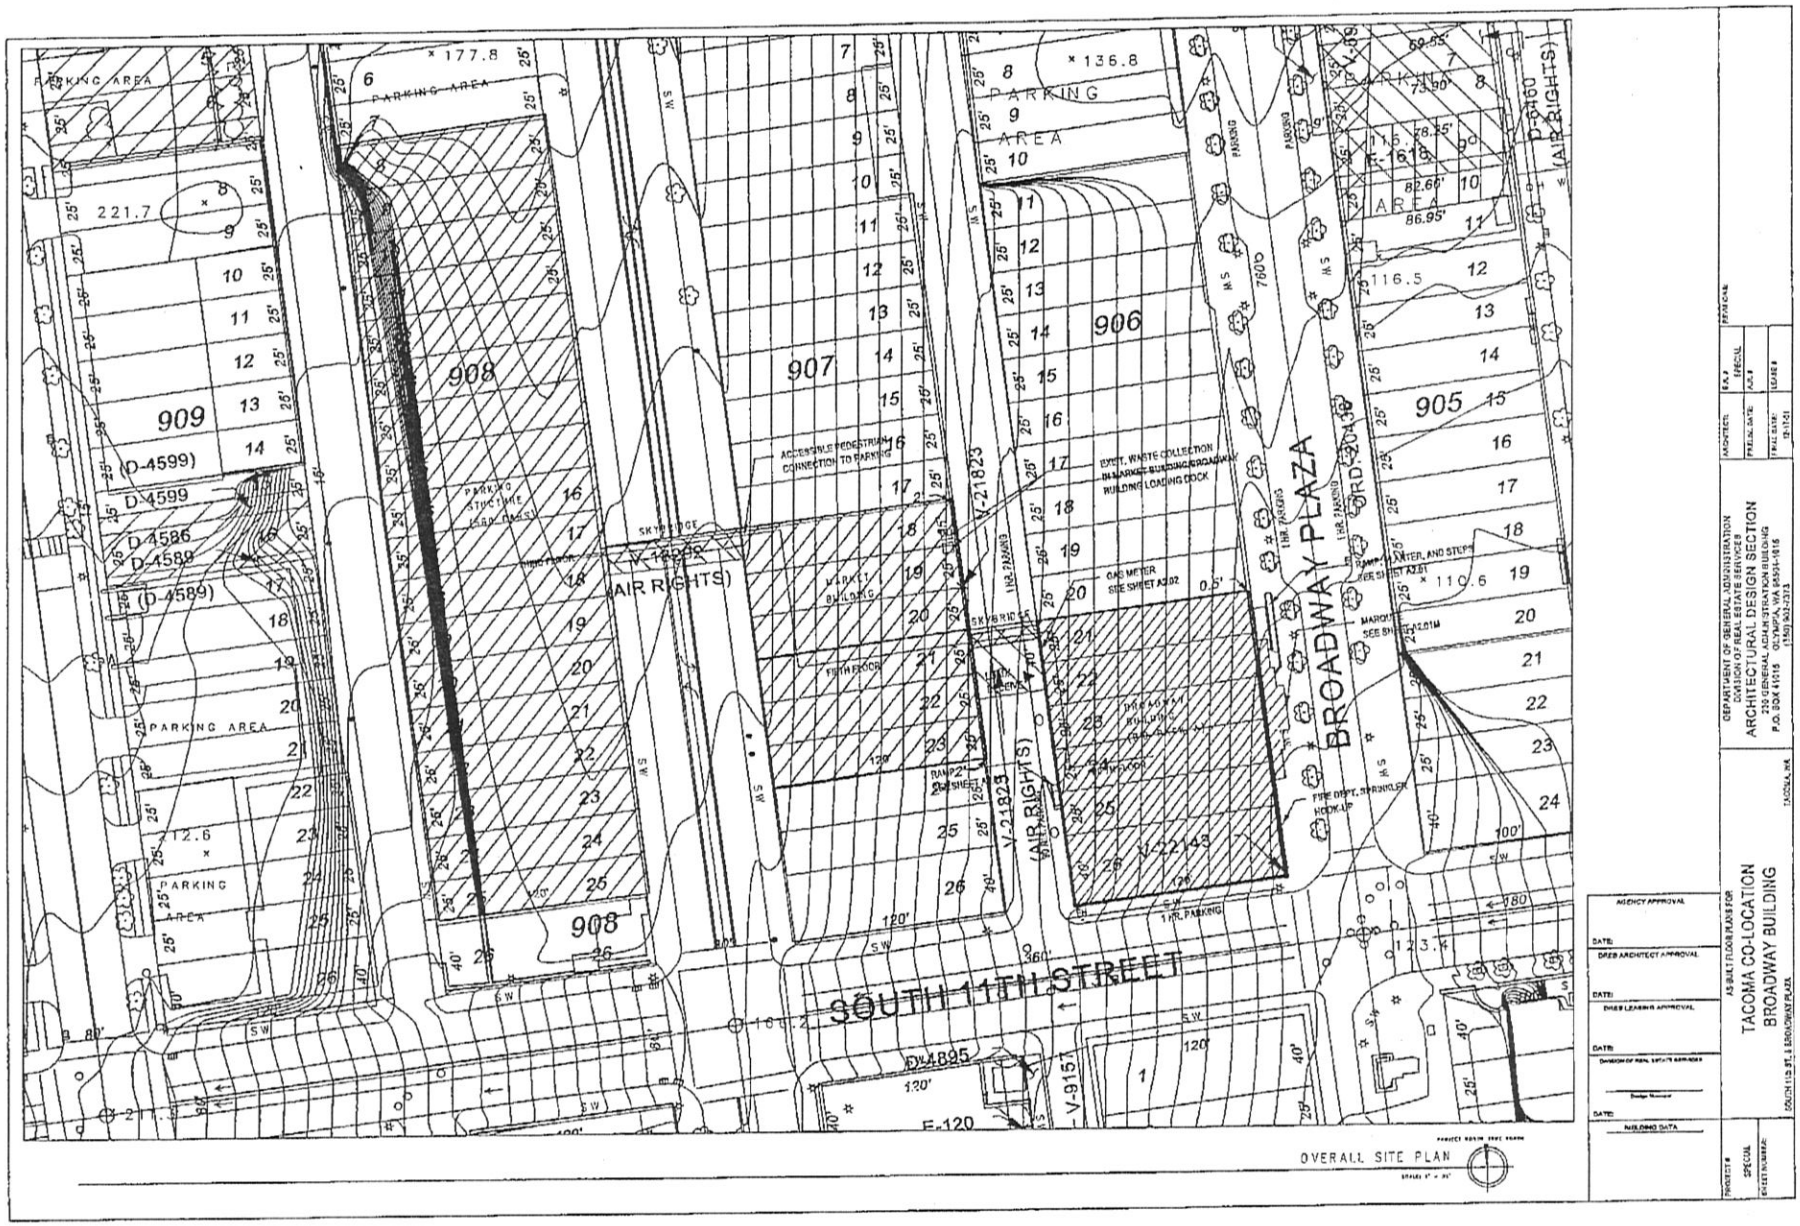

PARKING AREA
909
908
907
906
905
(D-4599)
D-4599
D-4586
D-4589
(D-4589)
V-18292
(AIR RIGHTS)
V-21823
V-22143
V-9157
D-4895
E-120
D-6460
(AIR RIGHTS)
SOUTH 11TH STREET
BROADWAY PLAZA
ACCESSIBLE PEDESTRIAN CONNECTION TO PARKING
EXIST. WASTE COLLECTION IN MARKET BUILDING/BROADWAY BUILDING LOADING DOCK
GAS METER SEE SHEET A2.02
FIRE DEPT. SPRINKLER HOOK-UP
MARQUE SEE SHEET A2.01M
RAMP, WATER, AND STEPS SEE SHEET A2.01
FIFTH FLOOR
1 HR. PARKING
OVERALL SITE PLAN
AGENCY APPROVAL
DATE:
DRES ARCHITECT APPROVAL
DATE:
DRES LEASING APPROVAL
DATE:
DATE:
BUILDING DATA
AS-BUILT FLOOR PLANS FOR
TACOMA CO-LOCATION
BROADWAY BUILDING
SOUTH 11th ST. & BROADWAY PLAZA
TACOMA, WA
DEPARTMENT OF GENERAL ADMINISTRATION
DIVISION OF REAL ESTATE SERVICES
ARCHITECTURAL DESIGN SECTION
220 GENERAL ADMINISTRATION BUILDING
P.O. BOX 41015 OLYMPIA, WA 98504-1015
(360) 902-7373
PROJECT #
SPECIAL
SHEET NUMBER:

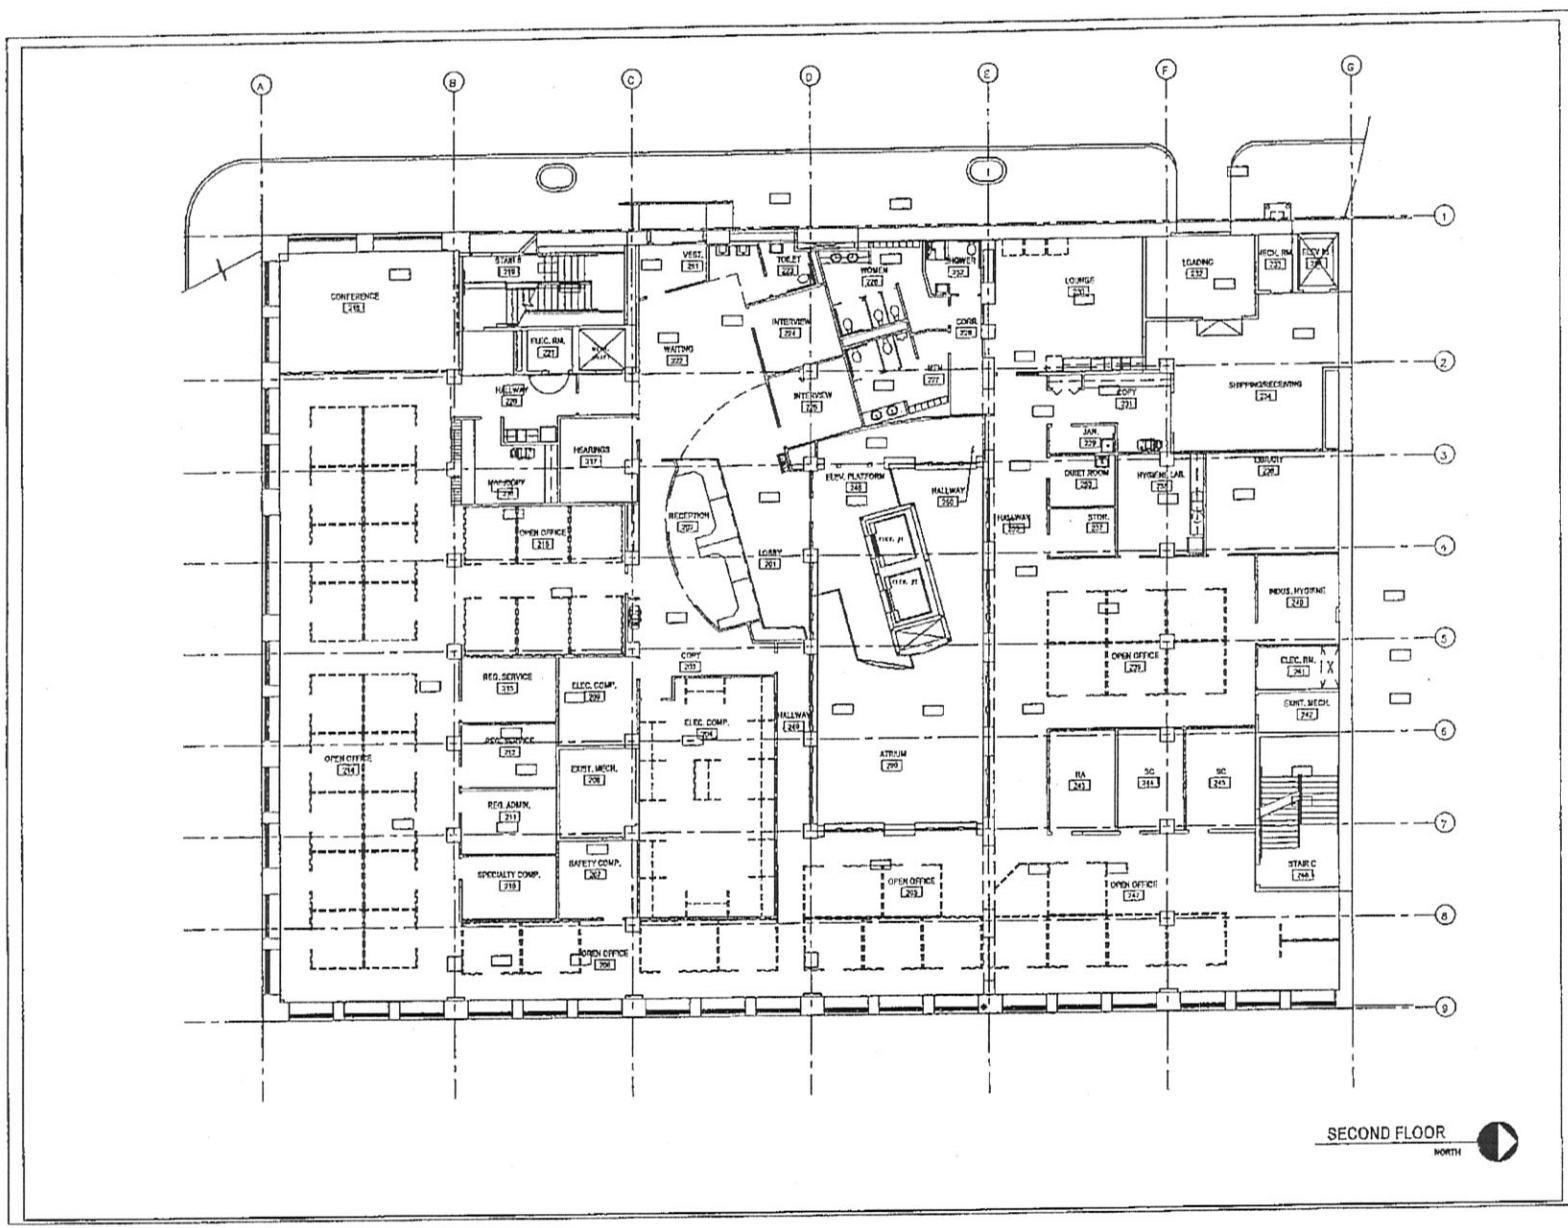

AGENCY APPROVAL	
DATE:	
DRES ARCHITECT APPROVAL	
DATE:	
DRES LEASING APPROVAL	
DATE:	
DIVISION OF REAL ESTATE SERVICES	
Design Manager	
DATE:	
BUILDING DATA	

PROJECT #: SPECIAL

SHEET NUMBER:

AS-BUILT FLOOR PLANS FOR

TACOMA CO-LOCATION BROADWAY BUILDING

SOUTH 11th ST. & BROADWAY PLAZA

TACOMA, WA

DEPARTMENT OF GENERAL ADMINISTRATION
DIVISION OF REAL ESTATE SERVICES
ARCHITECTURAL DESIGN SECTION
250 GENERAL ADMINISTRATION BUILDING
P.O. BOX 41015 OLYMPIA, WA 98504-1015
(360) 902-7023

ARCHITECT: E.A. #
SPECIAL
PRELIM. DATE: A.A. #
FINAL DATE: 2-14-02
LEAF #

REVISIONS:

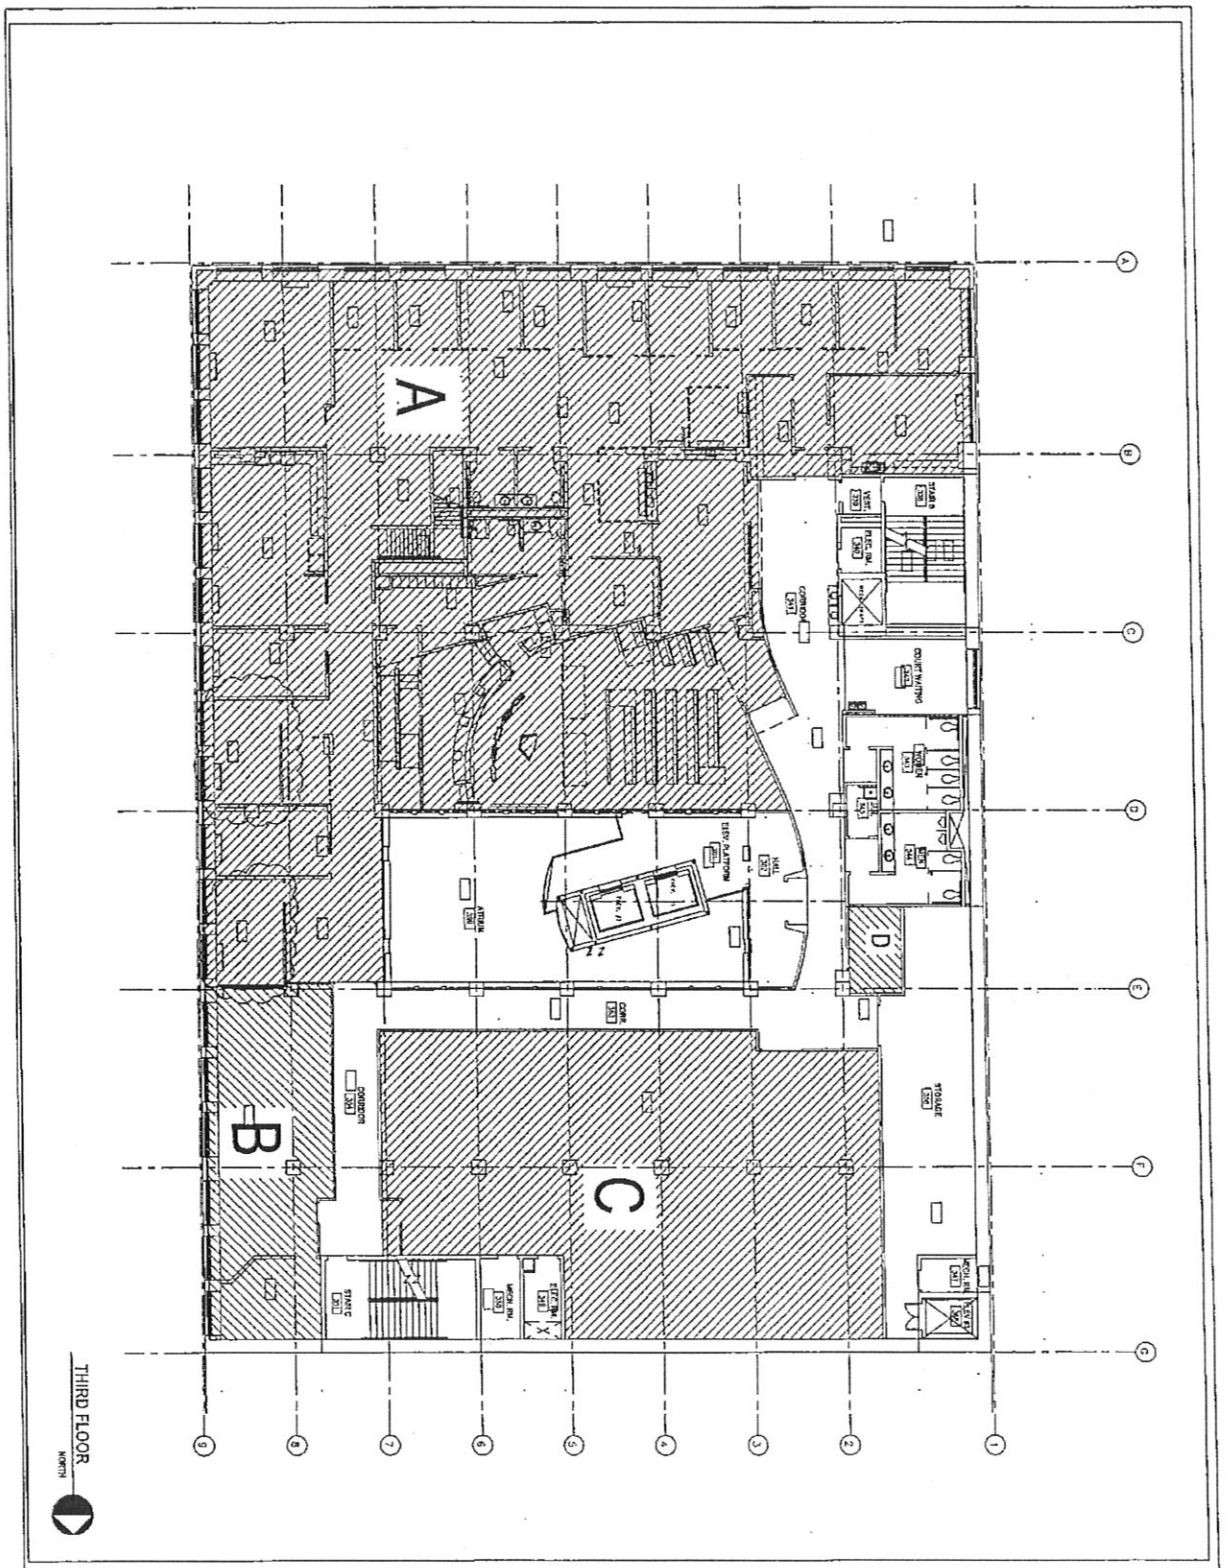

ARCHIV APPROVAL

DATE:

DRES ARCHITECT APPROVAL

DATE:

DRES LEASING APPROVAL

DATE:

DIVISION OF REAL ESTATE SERVICES

DATE:

BUILDING DATA

PROJECT # SPECIAL	AS-BUILT FLOOR PLANS FOR TACOMA CO-LOCATION BROADWAY BUILDING SOUTH 11th ST. & BROADWAY PLAZA TACOMA, WA	DEPARTMENT OF GENERAL ADMINISTRATION DIVISION OF REAL ESTATE SERVICES ARCHITECTURAL DESIGN SECTION 230 GENERAL ADMINISTRATION BUILDING P.O. BOX 41015 OLYMPIA, WA 98504-1015 (360) 902-7373	ARCHITECT:	R.R. # SPECIAL	REVISIONS:
SHEET NUMBER:			PRELIM. DATE:	A.R. #	
			FINAL DATE: 2-14-07	LEASE #	

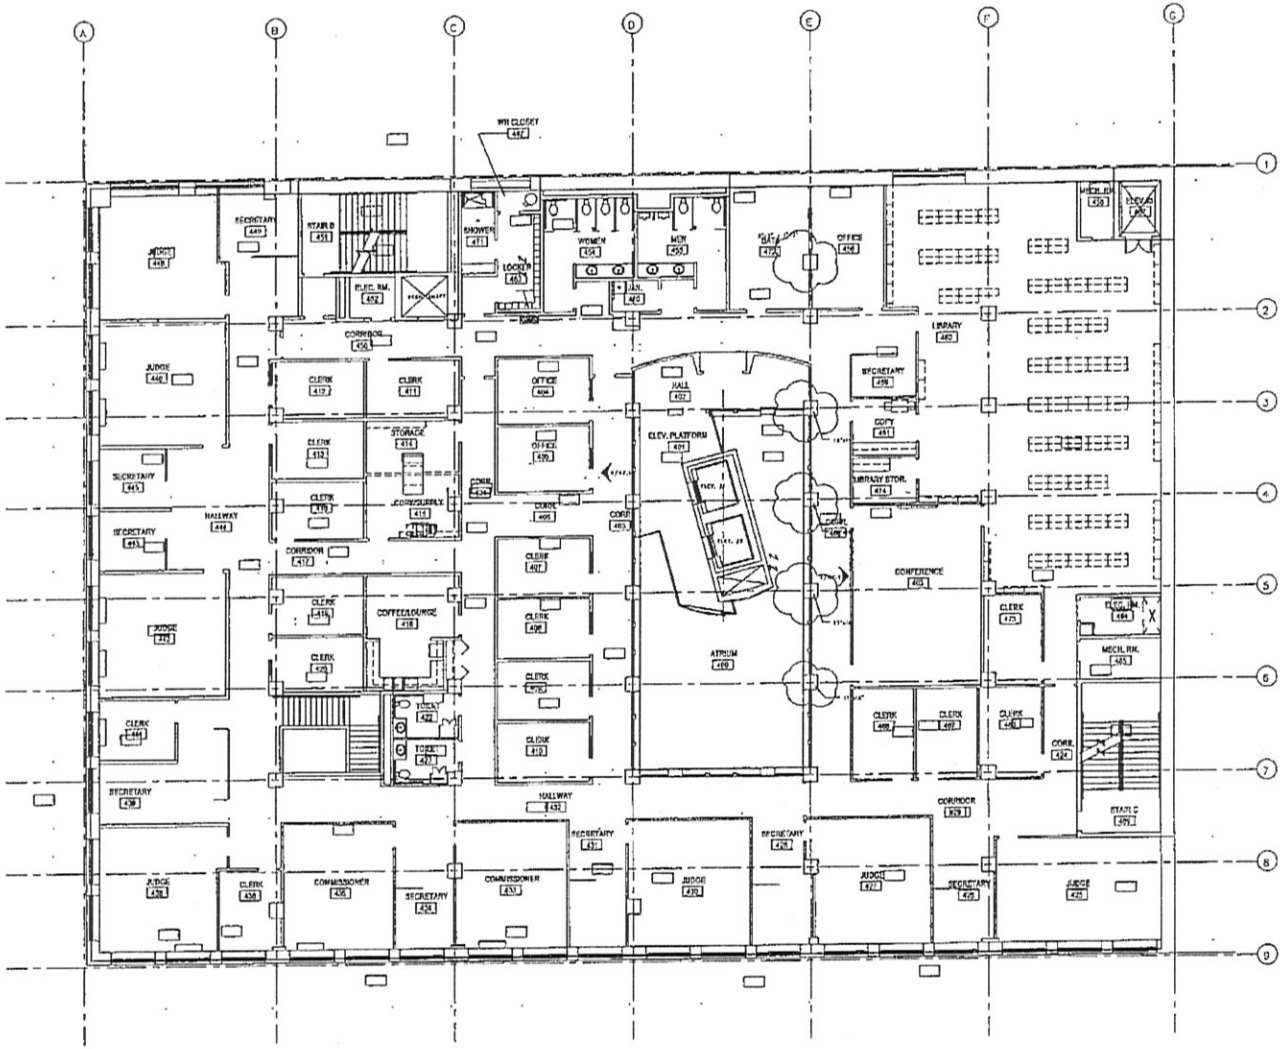

FOURTH FLOOR

NORTH

AGENCY APPROVAL

DATE:

DRES ARCHITECT APPROVAL

DATE:

DRES LEASING APPROVAL

DATE:

DIVISION OF REAL ESTATE SERVICES

Division Manager

DATE:

BUILDING DATA

AS-BUILT FLOOR PLANS FOR

TACOMA CO-LOCATION

BROADWAY BUILDING

SOUTH 11th ST. & BROADWAY PLAZA

TACOMA, WA

DEPARTMENT OF GENERAL ADMINISTRATION
DIVISION OF REAL ESTATE SERVICES
ARCHITECTURAL DESIGN SECTION
P.O. BOX 41015 OLYMPIA, WASHINGTON 98504-1015
(360) 902-7373

REVISIONS	A.R. #	SPECIAL
PRELIM. DATE	A.C. #	

REVISIONS

PROJECT # SPECIAL

SHEET NUMBER

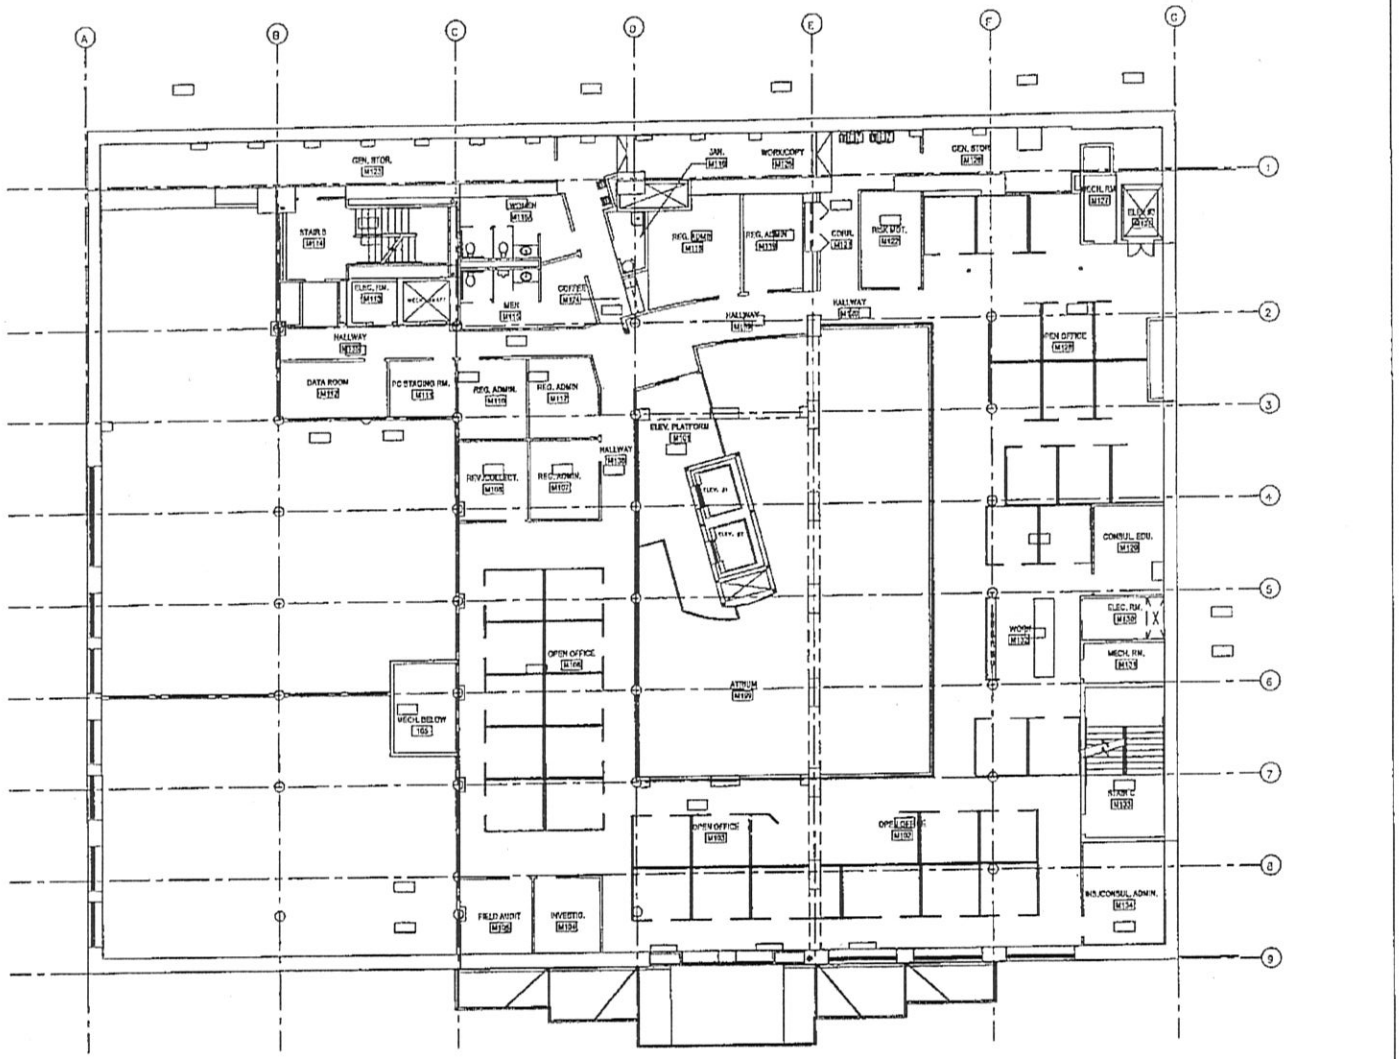

MEZZANINE

NORTH

AGENCY APPROVAL

DATE:

DGS ARCHITECT APPROVAL

DATE:

DGS LEASING APPROVAL

DATE:

DIVISION OF REAL ESTATE SERVICES

Design Manager

DATE:

BUILDING DATA

AS-BUILT INDICATION FOR

TACOMA CO-LOCATION

BROADWAY BUILDING

SOUTH 11th & BROADWAY PLAZA

TACOMA, WA.

PROJECT #

SPECIAL

SHEET/SHEETS:

REVISIONS:

DESIGNED: R.B.P.

DRAWN: SPECIAL

PREL. DATE: F.A.X.

FINAL DATE: LEASE #

3-14-03

DEPARTMENT OF GENERAL ADMINISTRATION

DIVISION OF REAL ESTATE SERVICES

ARCHITECTURAL DESIGN SECTION

350 GENERAL ADMINISTRATION BUILDING

P.O. BOX 41015 OLYMPIA, WA 98504-1015

(360) 902-7315

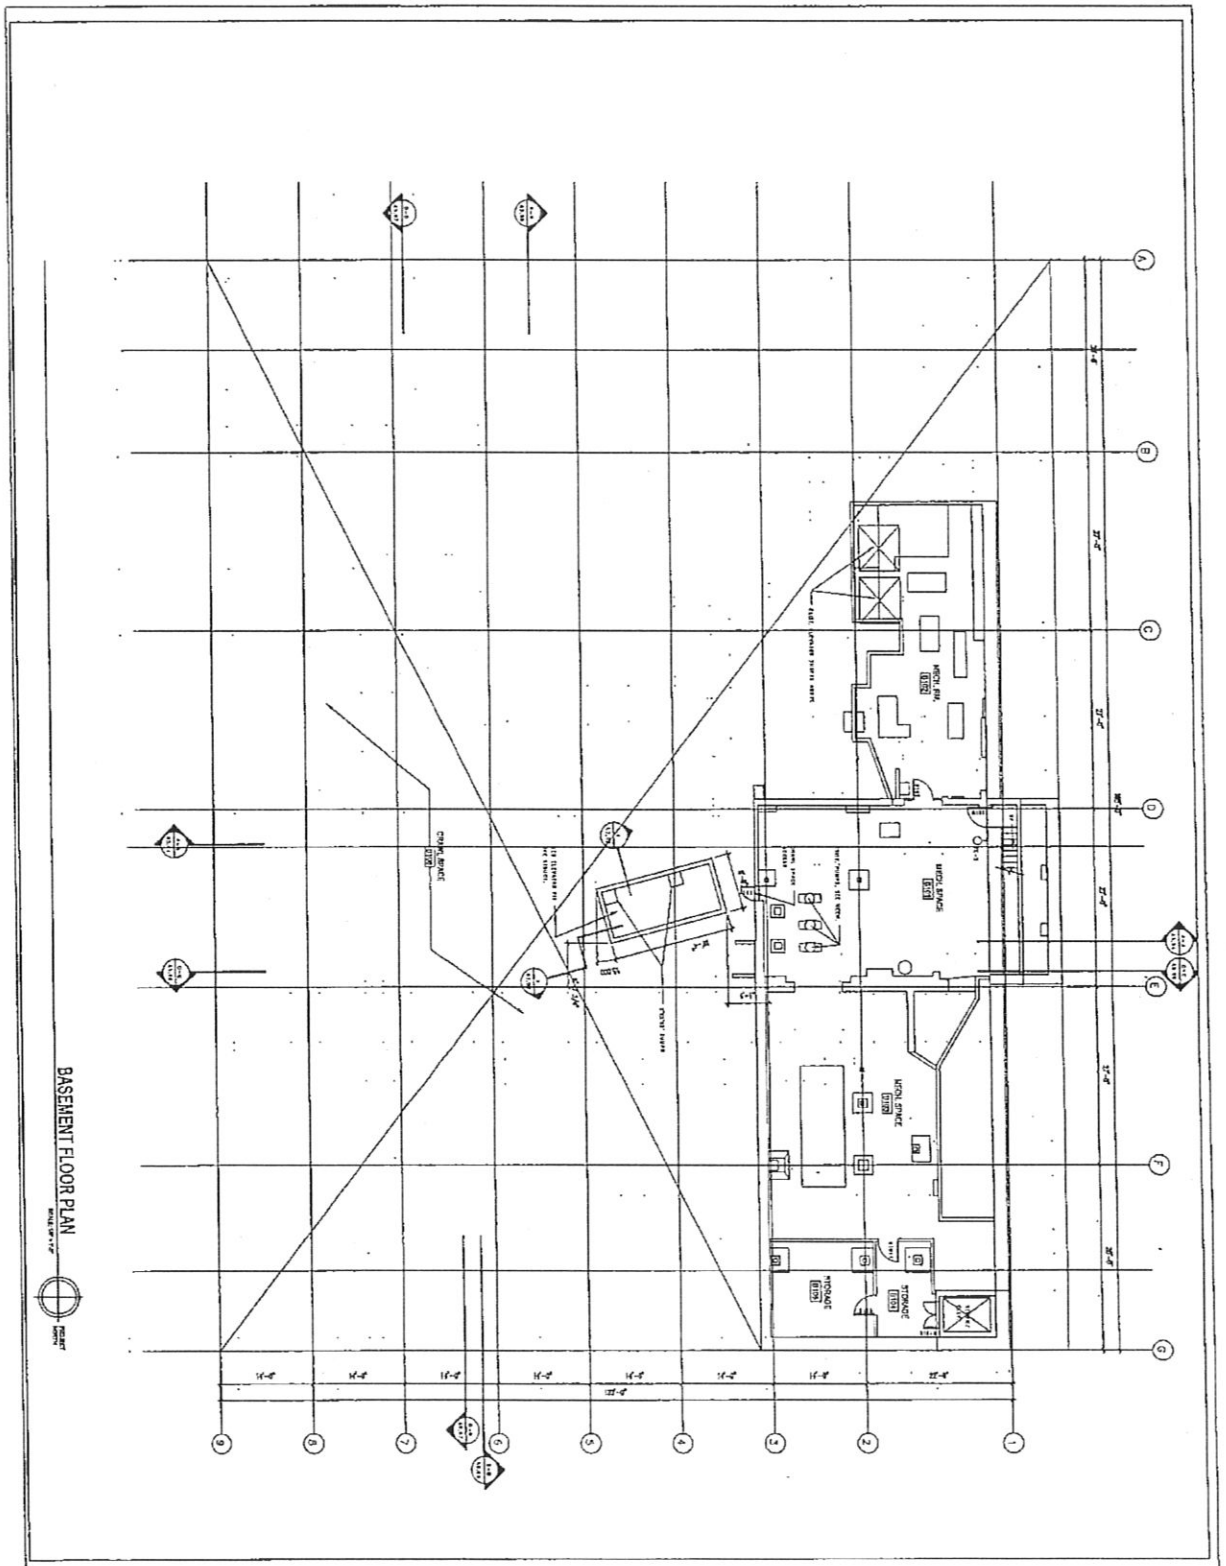

AGENCY APPROVAL

DATE:

DESIGN ARCHITECT APPROVAL

DATE:

PAGE LEASING APPROVAL

DATE:

DIVISION OF REAL ESTATE SERVICES

DATE:

BUILDING DATA

PROJECT # SPECIAL	AS-BUILT FLOOR PLANS FOR TACOMA CO-LOCATION BROADWAY BUILDING SOUTH 11th ST. & BROADWAY PLAZA TACOMA, WA	DEPARTMENT OF GENERAL ADMINISTRATION DIVISION OF REAL ESTATE SERVICES ARCHITECTURAL DESIGN SECTION 230 GENERAL ADMINISTRATION BUILDING P.O. BOX 41015 OLYMPIA, WA 98504-1015 (360) 902-7373	ARCHITECT:	B.R. # SPECIAL	REVISIONS:
SHEET NUMBER:			PRELIM. DATE:	A.A. #	
			FINAL DATE: 12-17-01	LEASE #	

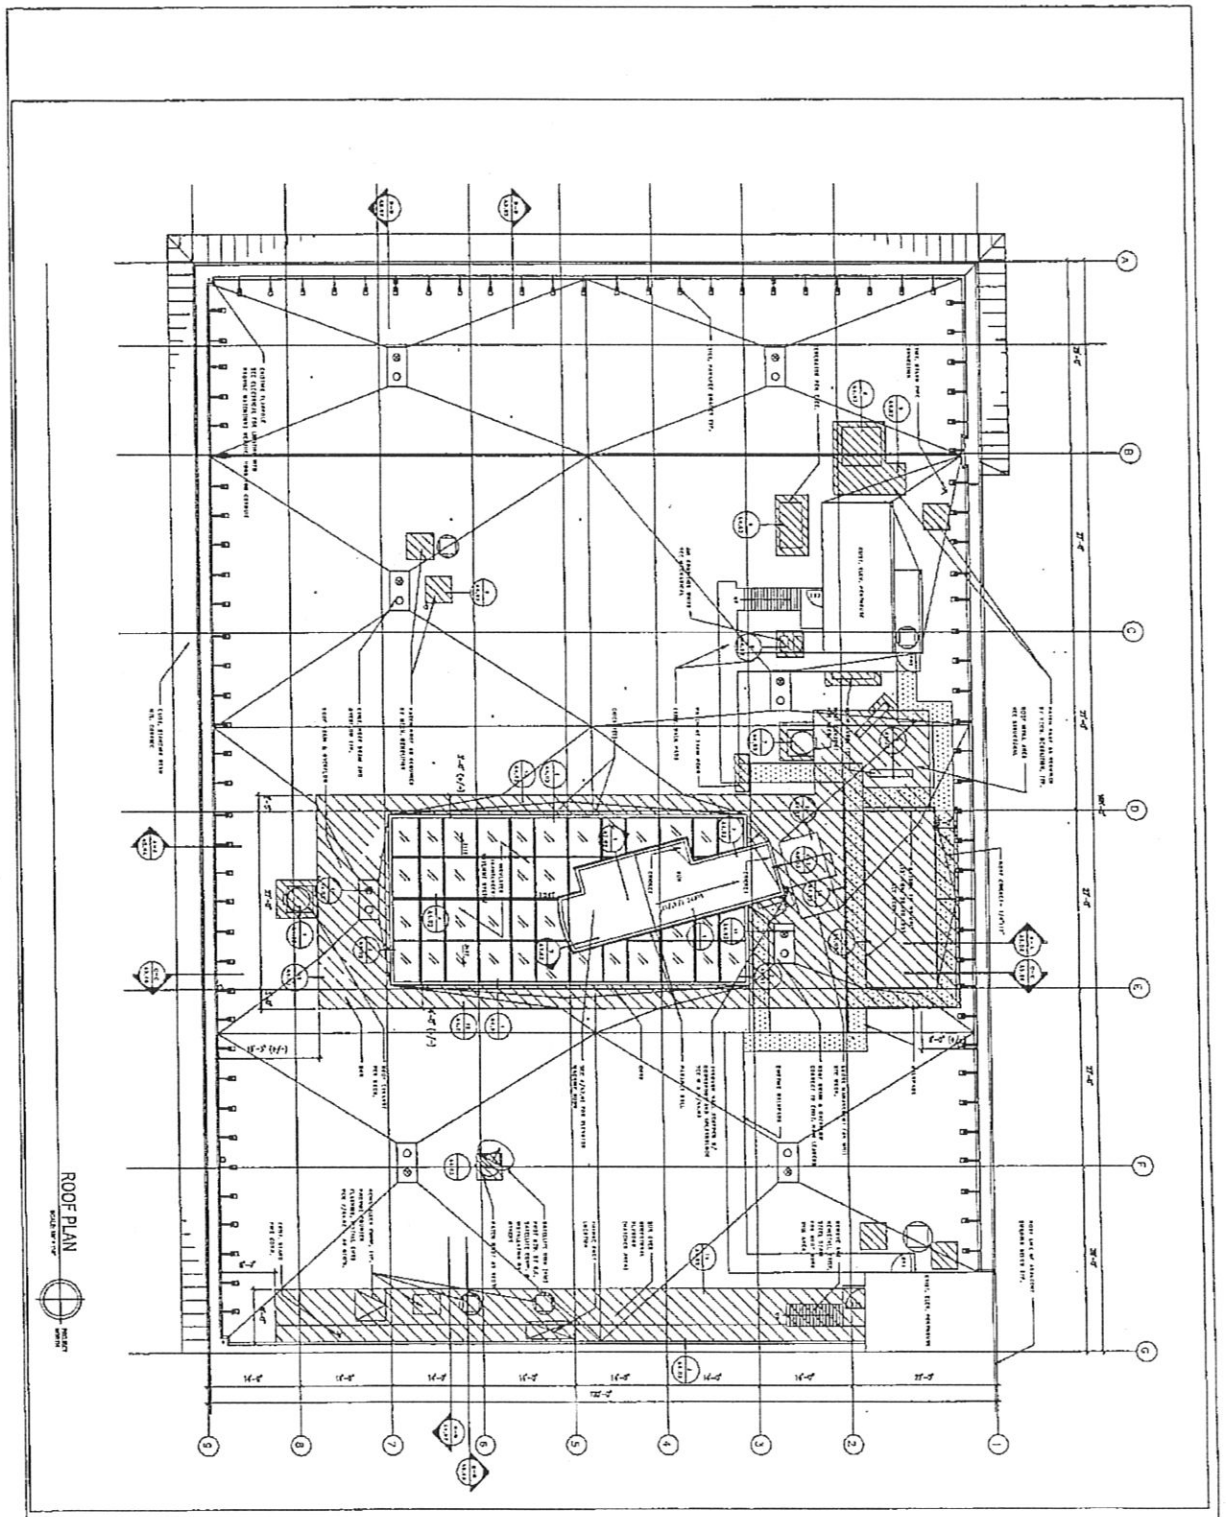

ADVISORY APPROVAL	DATE:	DIVISION OF REAL ESTATE SERVICES	DATE:	DIVISION OF REAL ESTATE SERVICES	DATE:
DATE:	DATE:				
BUILDING DATA					

PROJECT # SPECIAL	AS-BUILT FLOOR PLANS FOR TACOMA CO-LOCATION BROADWAY BUILDING	DEPARTMENT OF GENERAL ADMINISTRATION DIVISION OF REAL ESTATE SERVICES ARCHITECTURAL DESIGN SECTION 336 GENERAL ADMINISTRATION BUILDING P.O. BOX 41015 OLYMPIA, WA 98504-1015 (360) 902-7373	ARCHITECT:	B.L.# SPECIAL	REVISIONS:
SHEET NUMBER:	SOUTH 11th ST. & BROADWAY PLAZA TACOMA, WA		FINAL DATE: 12-17-01	LEASE #	

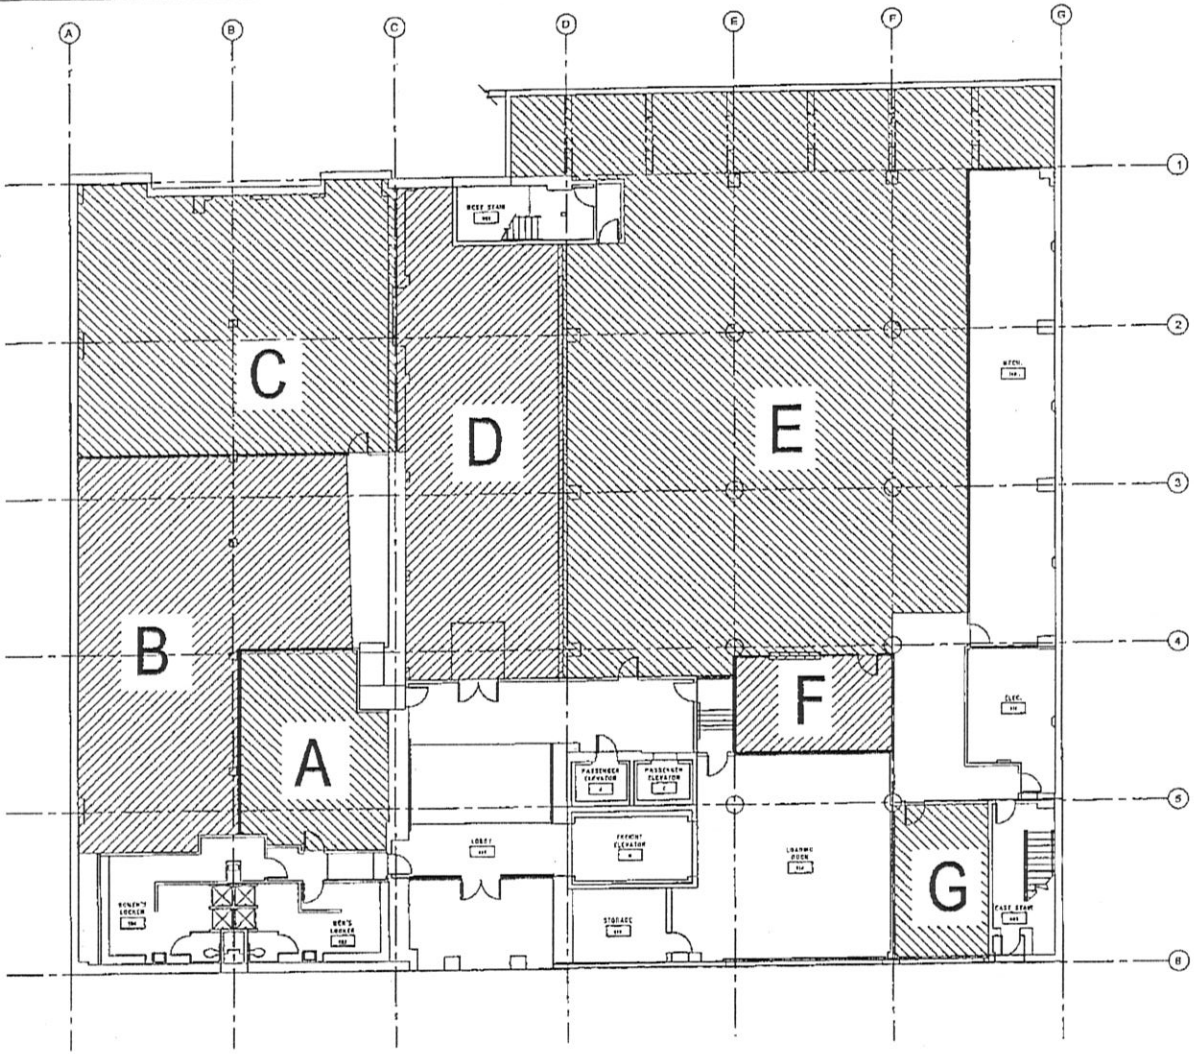

FIRST FLOOR
NORTH

AGENCY APPROVAL
DATE:
DRES ARCHITECT APPROVAL
DATE:
DRES LEASING APPROVAL
DATE:
DIVISION OF REAL ESTATE SERVICES
Director Manager
DATE:
BUILDING DATA

DEPARTMENT OF GENERAL ADMINISTRATION
DIVISION OF REAL ESTATE SERVICES
ARCHITECTURAL DESIGN SECTION
250 GENERAL ADMINISTRATION BUILDING
P.O. BOX 41015 OLYMPIA, WA 98504-1015
(360) 902-7373

AS-BUILT FLOOR PLANS FOR
TACOMA CO-LOCATION
MARKET BUILDING
SOUTH 11th ST. & BROADWAY PLAZA
TACOMA, WA

PROJECT #
SPECIAL
MARKET NUMBER:

ARCHITECT:
PRELIM. DATE:
FINAL DATE:
2-16-02
E.R. #
SPECIAL
A.R. #
LEASE #
REVISIONS:

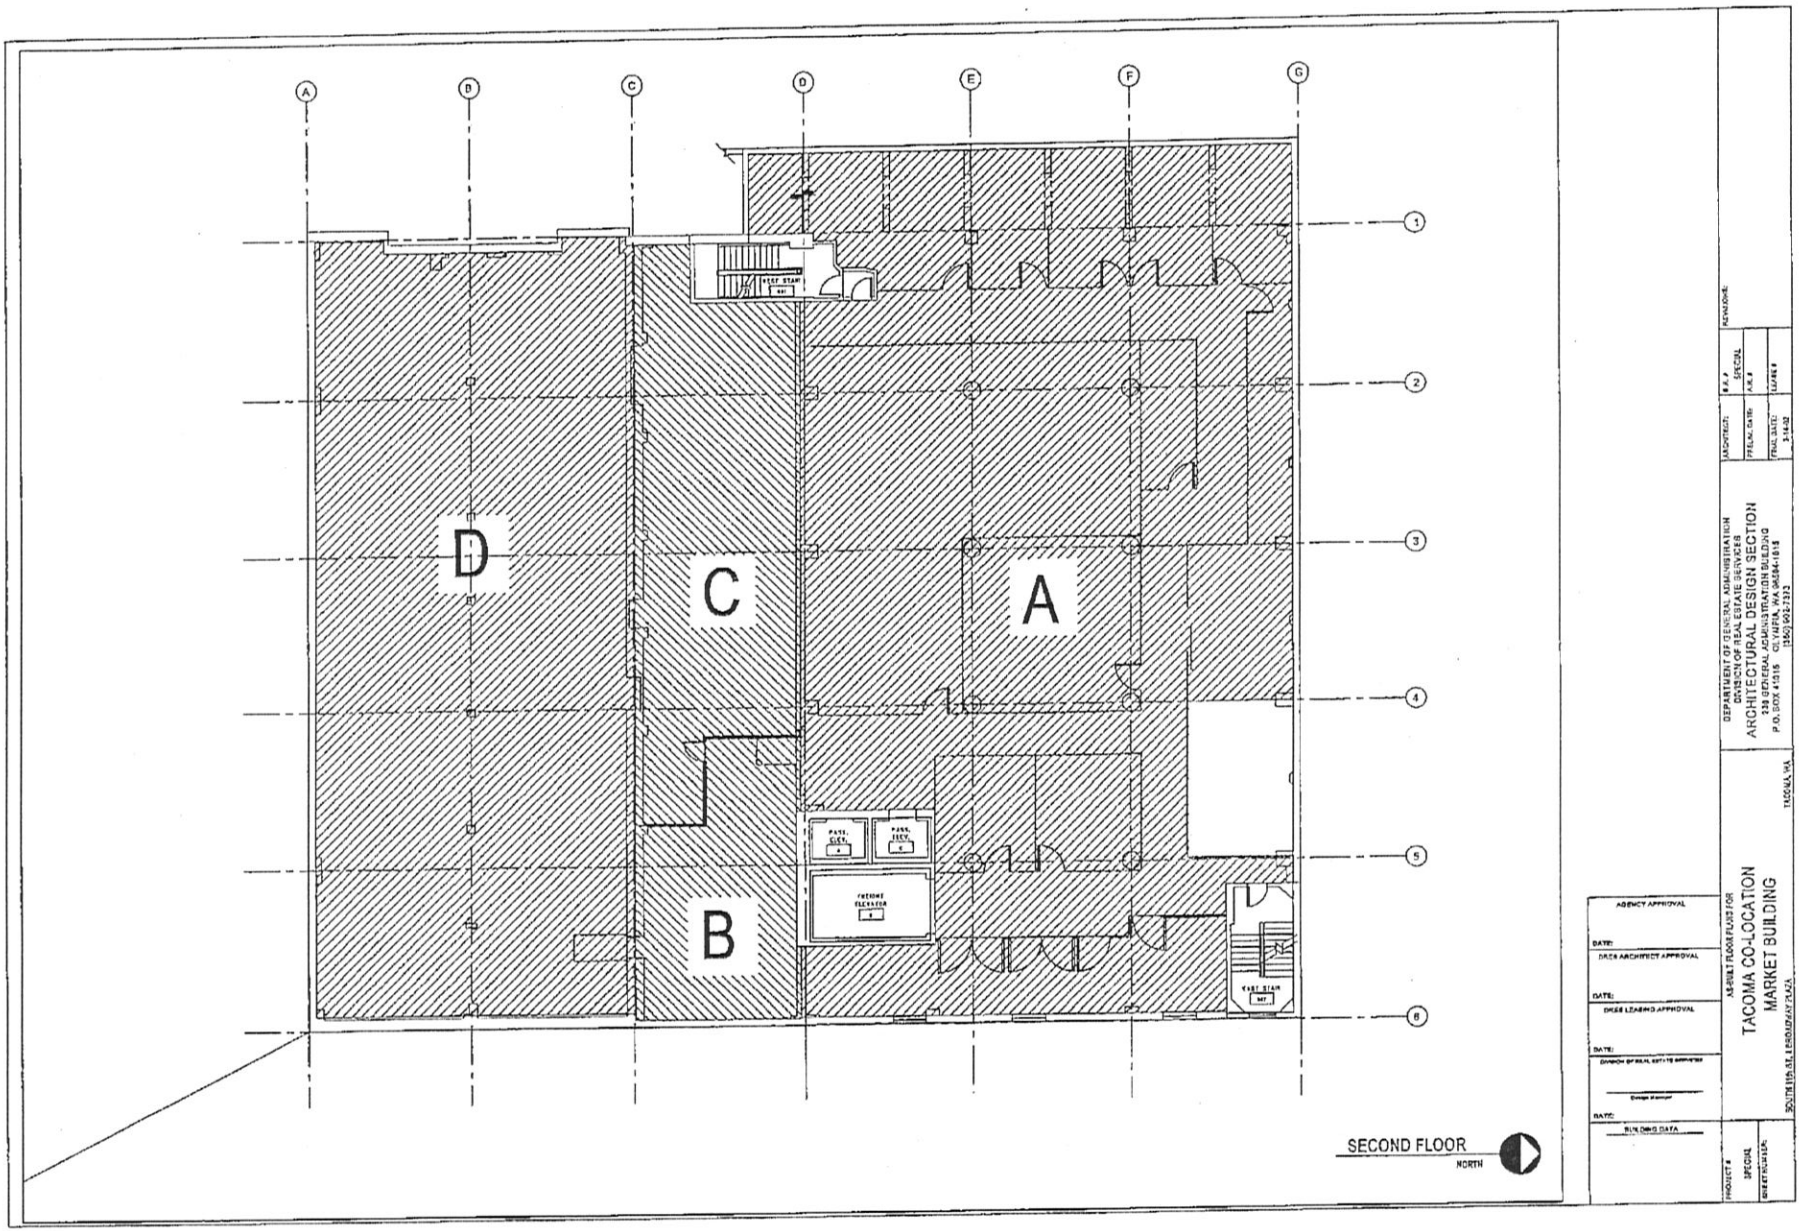

A
B
C
D
E
F
G
1
2
3
4
5
6
WEST STAIR
PASS. ELEV.
FREIGHT ELEVATOR
EAST STAIR
SECOND FLOOR
NORTH
AGENCY APPROVAL
DATE:
DRES ARCHITECT APPROVAL
DATE:
DRES LEASING APPROVAL
DATE:
DIVISION OF REAL ESTATE SERVICES
Design Manager
DATE:
BUILDING DATA
PROJECT #
SPECIAL
SHEET NUMBER:
AS-BUILT FLOOR PLANS FOR
TACOMA CO-LOCATION
MARKET BUILDING
SOUTH 11th ST. LIBROADWAY PLAZA
TACOMA, WA
DEPARTMENT OF GENERAL ADMINISTRATION
DIVISION OF REAL ESTATE SERVICES
ARCHITECTURAL DESIGN SECTION
230 GENERAL ADMINISTRATION BUILDING
P.O. BOX 41015 OLYMPIA, WA 98504-1015
(360) 902-7373
ARCHITECT:
PRELIM. DATE:
FINAL DATE:
3-14-02
R.A. #
SPECIAL
A.R. #
LEASE #
REVISIONS:

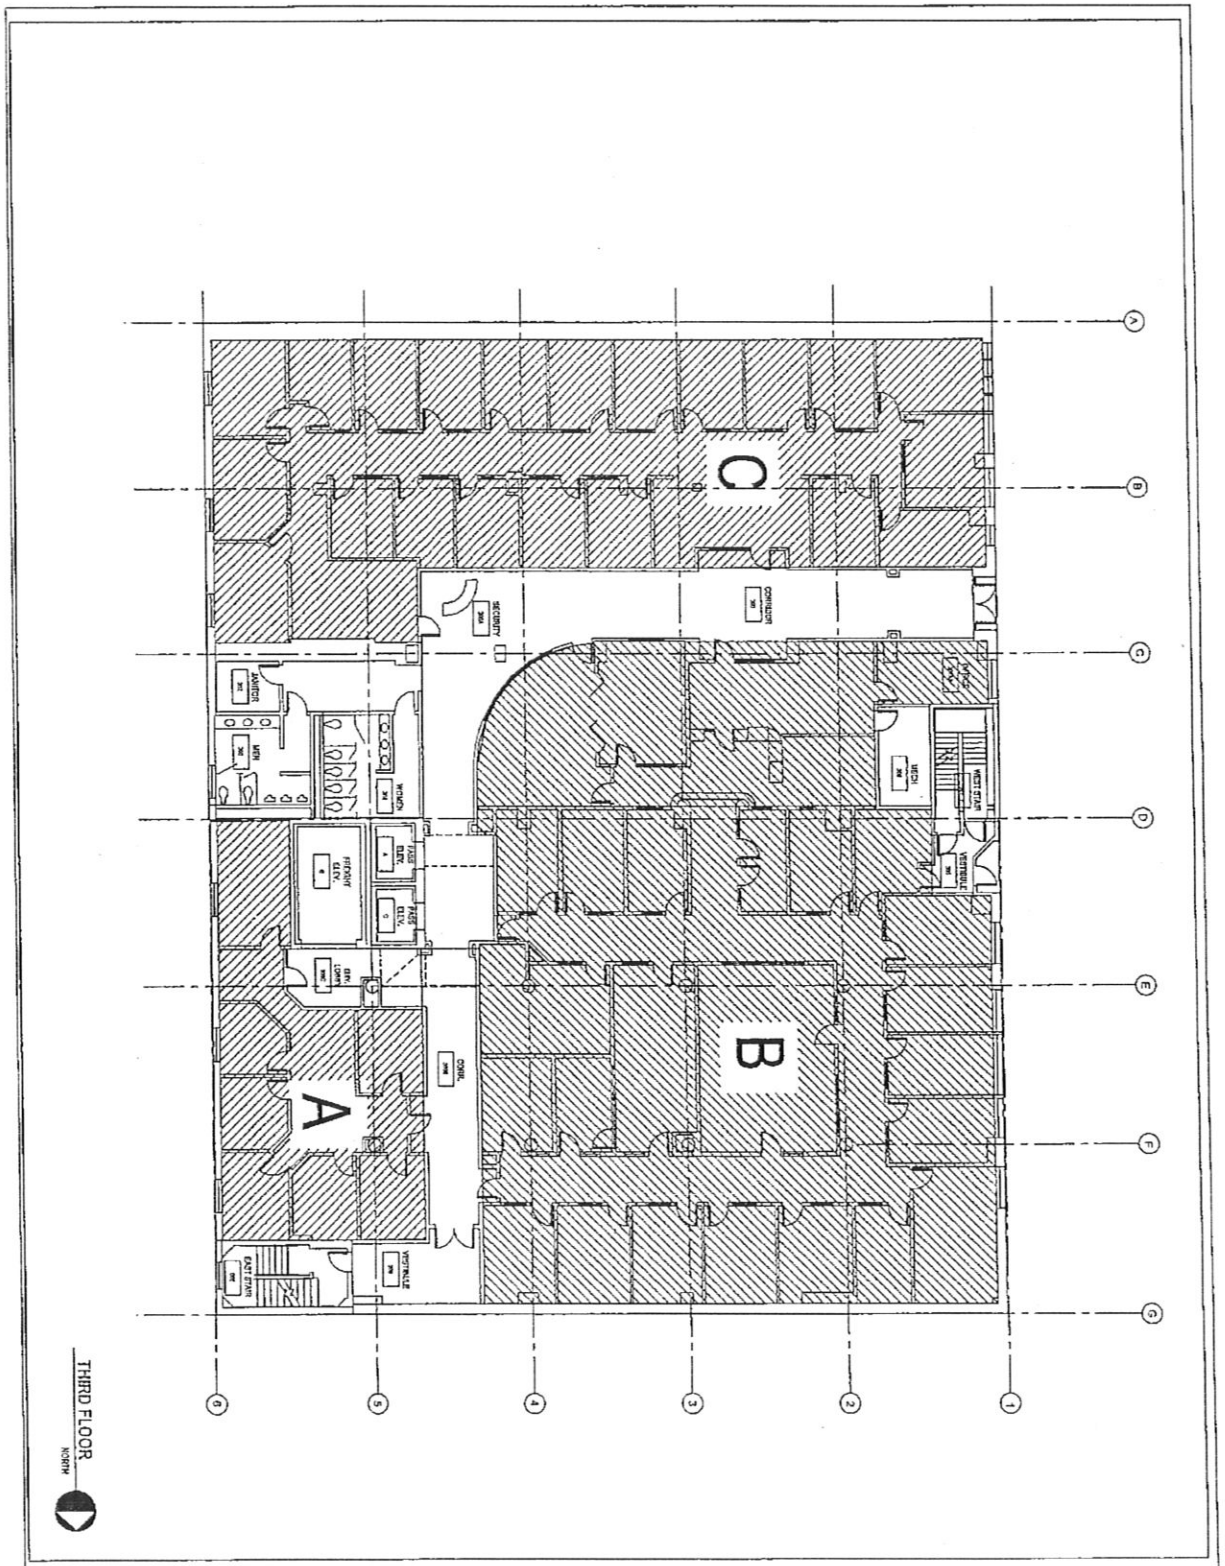

AGENCY APPROVAL

DATE:

DIVISION ARCHITECT APPROVAL

DATE:

DIVISION LEASING APPROVAL

DATE:

DIVISION OF REAL ESTATE SERVICES

DATE:

BUILDING DATA

PROJECT # SPECIAL	AS-BUILT FLOOR PLANS FOR TACOMA CO-LOCATION MARKET BUILDING SOUTH 11th ST. & BROADWAY PLAZA TACOMA, WA	DEPARTMENT OF GENERAL ADMINISTRATION DIVISION OF REAL ESTATE SERVICES ARCHITECTURAL DESIGN SECTION 230 GENERAL ADMINISTRATION BUILDING P.O. BOX 41016 OLYMPIA, WA 98504-1016 (360) 902-7373	ARCHITECT:	B.R. # SPECIAL	REVISIONS:
SHEET NUMBER:			PRELIM. DATE:	A.R. #	
			FINAL DATE: 2-14-02	LEASE #	

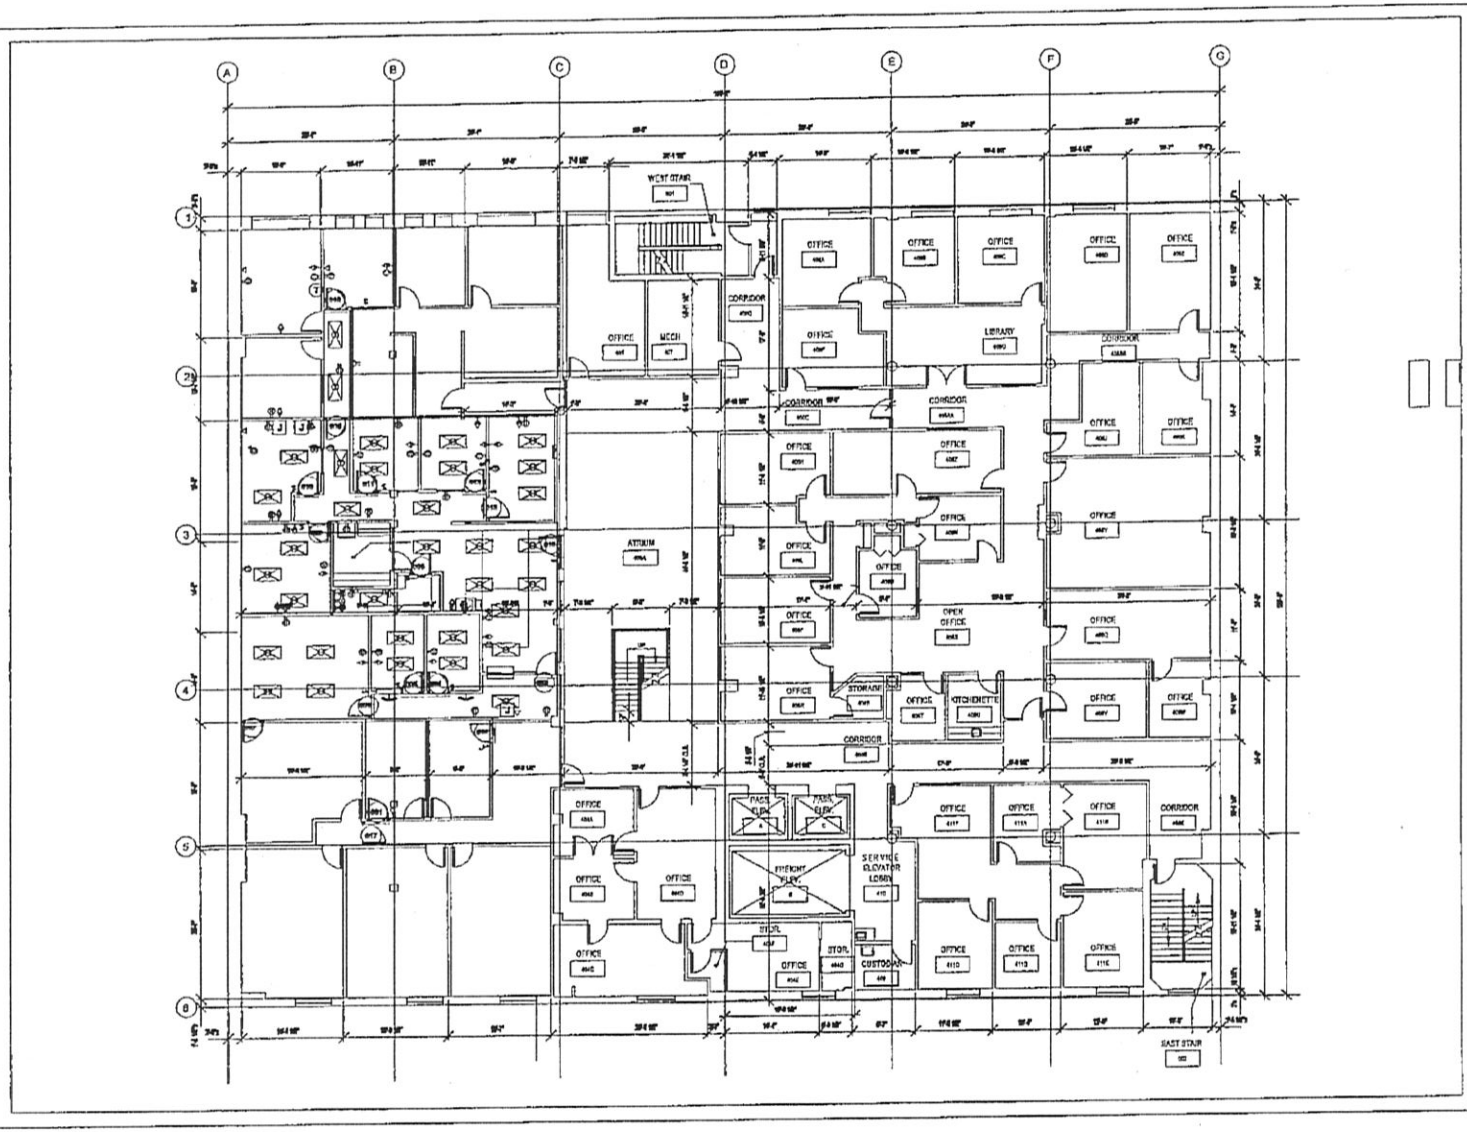

NORTH

FOURTH FLOOR PLAN - MARKET BUILDING

SCALE: 1/8"=1'-0"

AGENCY APPROVAL

DATE:

DRES ARCHITECT APPROVAL

DATE:

DRES LEASING APPROVAL

DATE:

DIVISION OF REAL ESTATE SERVICES

Design Manager

DATE:

BUILDING DATA

PROJECT #: SPECIAL

CHEST NUMBER:

AS-BUILT FLOOR PLANS FOR

TACOMA CO-LOCATION

MARKET BUILDING

SOUTH 13th ST. & BROADWAY PLAZA

TACOMA, WA

DEPARTMENT OF GENERAL ADMINISTRATION
DIVISION OF REAL ESTATE SERVICES
ARCHITECTURAL DESIGN SECTION
230 GENERAL ADMINISTRATION BUILDING
P.O. BOX 41015 OLYMPIA, WA 98504-1015
(360) 902-7333

FACILITY: | R.R. # SPECIAL | REVISIONS:

PRELIM. DATE: | APL # | LEASE #

FINAL DATE: 12-17-01

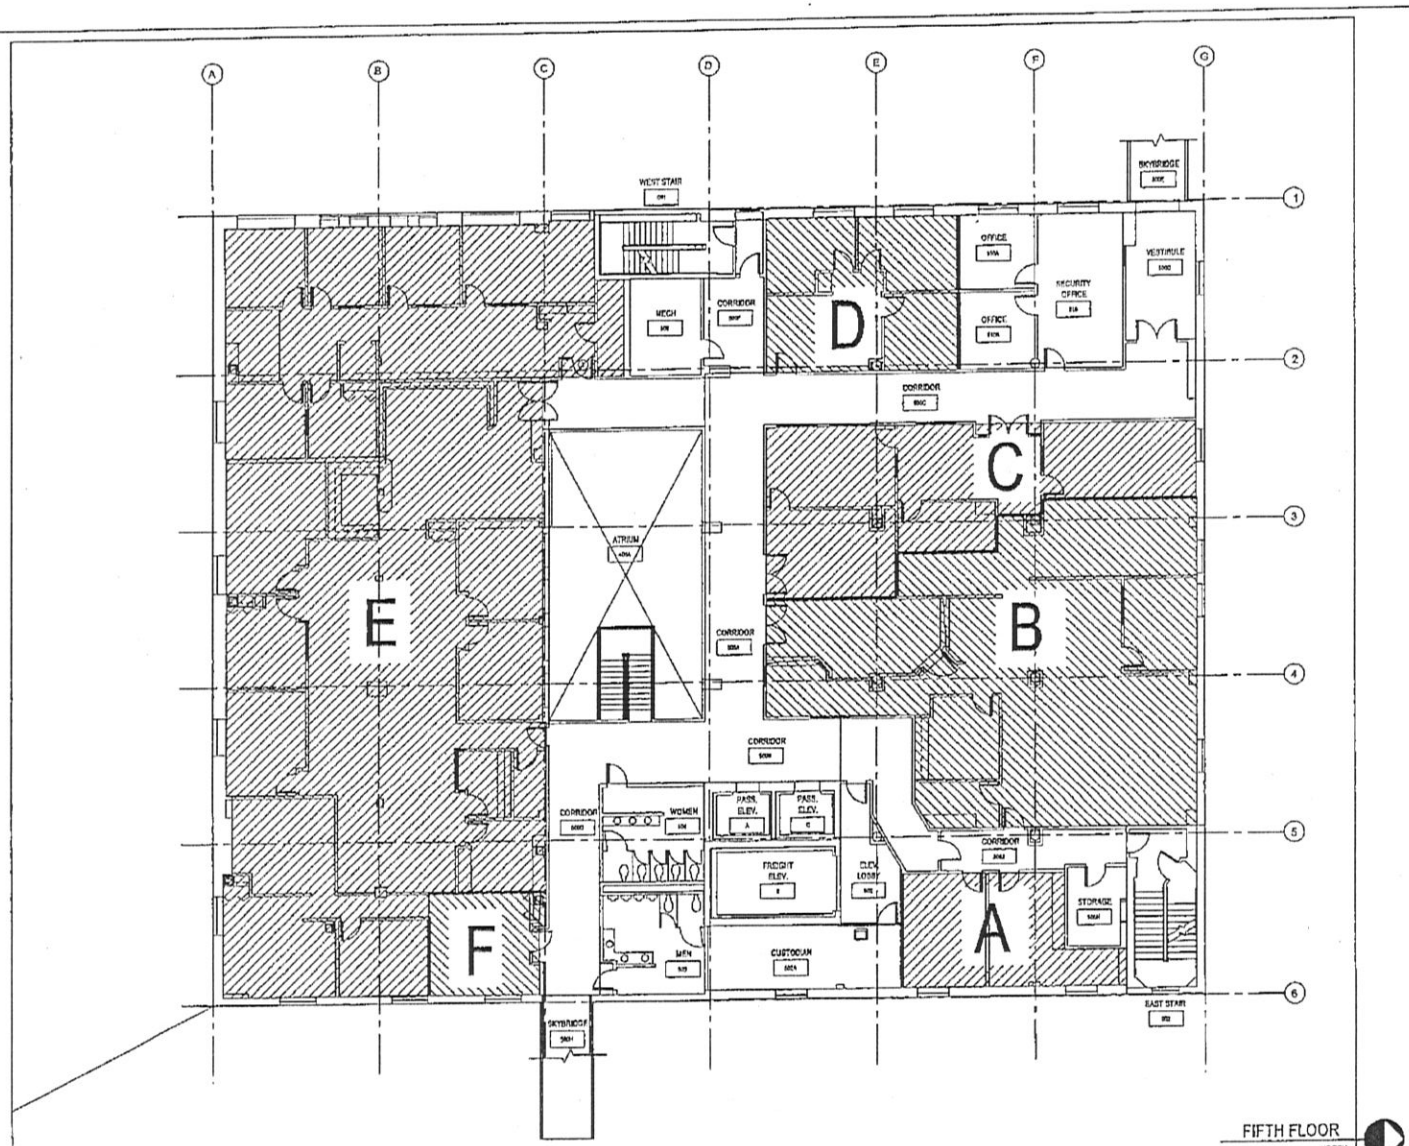

AGENCY APPROVAL

DATE:

DRES ARCHITECT APPROVAL

DATE:

DRES LEASING APPROVAL

DATE:

DIVISION OF REAL ESTATE SERVICES

DATE:

BUILDING DATA

DEPARTMENT OF GENERAL ADMINISTRATION
DIVISION OF REAL ESTATE SERVICES
ARCHITECTURAL DESIGN SECTION
230 GENERAL ADMINISTRATION BUILDING
P.O. BOX 41015 OLYMPIA, WA 98504-1015
(360) 902-7273

AS-BUILT FLOOR PLANS FOR
TACOMA CO-LOCATION
MARKET BUILDING
SOUTH 11th ST. & SROAD/WAY PLAZA
TACOMA, WA

PROJECT #
SPECIAL
SHEET NUMBER:

ARCHITECT:
R.A. #
SPECIAL
PRELIM. DATE:
A.R. #
FINAL DATE:
LEASE #
2-14-22

REVISIONS:

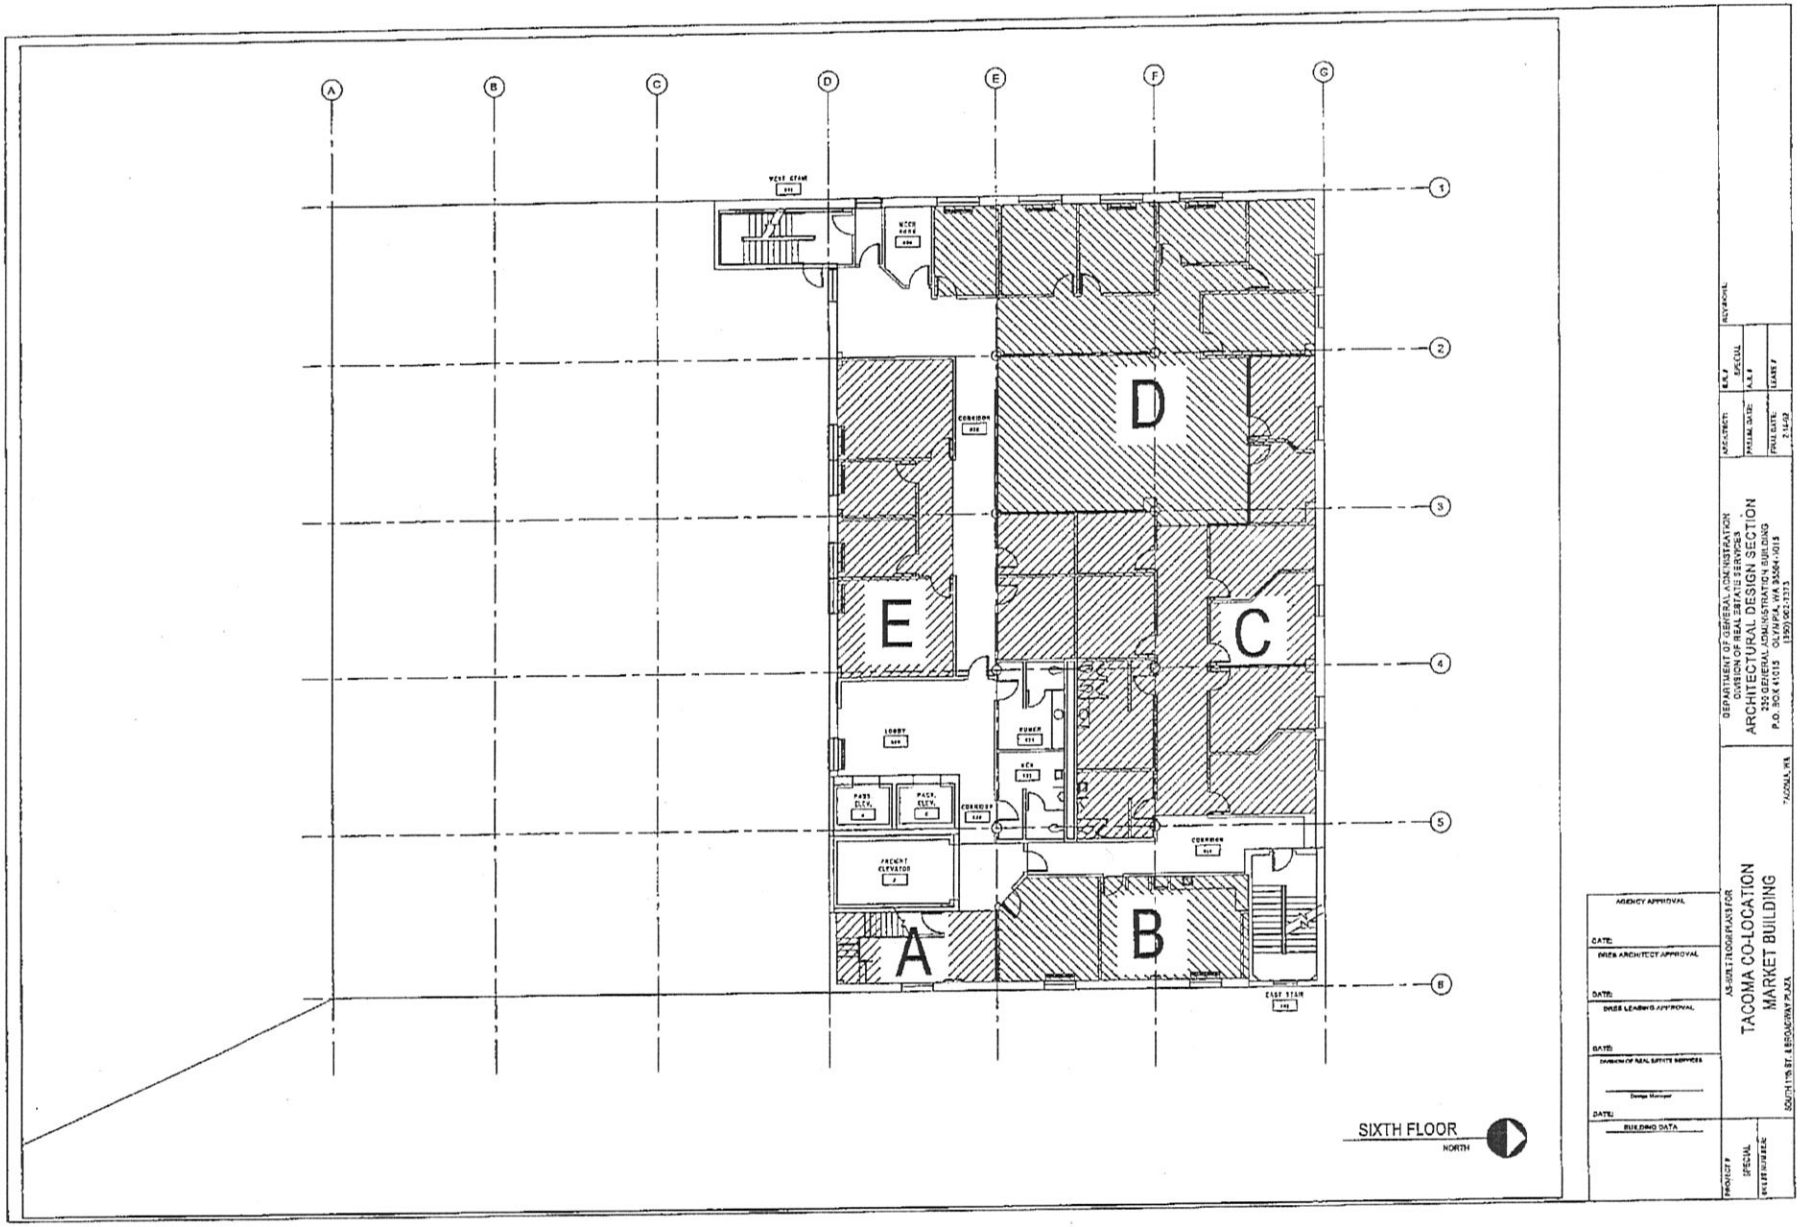

A
B
C
D
E
F
G
1
2
3
4
5
6
WEST STAIR
MECH ROOM
CORRIDOR
LOBBY
POWER
KEY
PASS. ELEV.
FREIGHT ELEVATOR
EAST STAIR
SIXTH FLOOR
NORTH
AGENCY APPROVAL
DATE:
DRES ARCHITECT APPROVAL
DATE:
DRES LEASING APPROVAL
DATE:
DIVISION OF REAL ESTATE SERVICES
Design Manager
DATE:
BUILDING DATA
DEPARTMENT OF GENERAL ADMINISTRATION
DIVISION OF REAL ESTATE SERVICES
ARCHITECTURAL DESIGN SECTION
250 GENERAL ADMINISTRATION BUILDING
P.O. BOX 41015 OLYMPIA, WA 98504-1015
(360) 902-7373
TACOMA, WA
AS-BUILT FLOOR PLANS FOR
TACOMA CO-LOCATION
MARKET BUILDING
SOUTH 11th ST. & BROADWAY PLAZA
PROJECT #
SPECIAL
SHEET NUMBER:
ARCHITECT:
PRELIM. DATE:
FINAL DATE:
2-14-92
R.R.#
SPECIAL
A.R.#
LEASE #
REVISIONS:

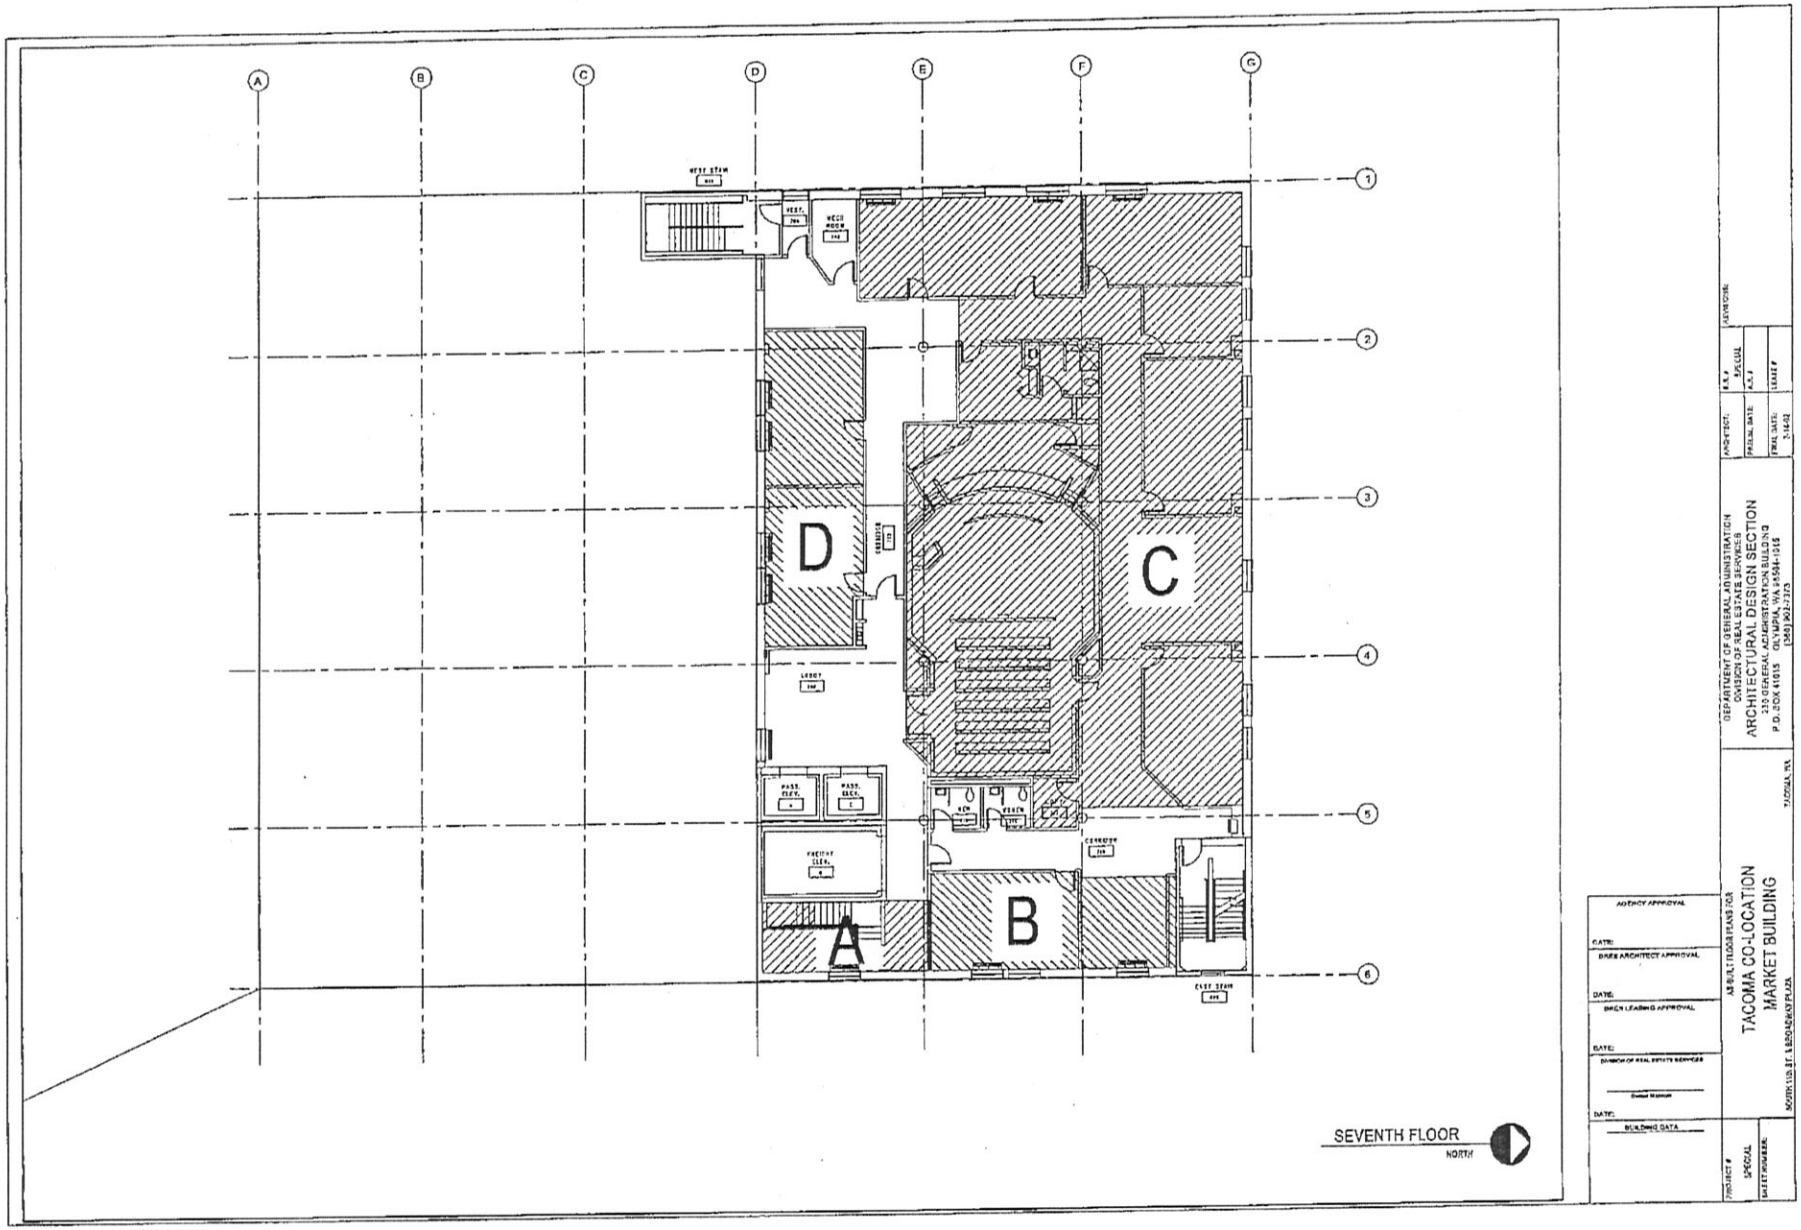

A
B
C
D
E
F
G
1
2
3
4
5
6
WEST STAIR
VEST.
MECH ROOM
CORRIDOR
LOBBY
MASS. ELEV.
FREIGHT ELEV.
MEN
WOMEN
CORRIDOR
EAST STAIR
SEVENTH FLOOR
NORTH
AGENCY APPROVAL
DATE:
DRES ARCHITECT APPROVAL
DATE:
DRES LEASING APPROVAL
DATE:
DIVISION OF REAL ESTATE SERVICES
DATE:
BUILDING DATA
PROJECT #
SPECIAL
SHEET NUMBER:
AS-BUILT FLOOR PLANS FOR
TACOMA CO-LOCATION
MARKET BUILDING
SOUTH 11th ST. & BROADWAY PLAZA
TACOMA, WA
DEPARTMENT OF GENERAL ADMINISTRATION
DIVISION OF REAL ESTATE SERVICES
ARCHITECTURAL DESIGN SECTION
230 GENERAL ADMINISTRATION BUILDING
P.O. BOX 41015 OLYMPIA, WA 98504-1015
(360) 902-7373
ARCHITECT:
PRELIM. DATE:
FINAL DATE:
3-14-02
R.R.#
R/PECIAL
A.R.#
LEASE #
REVISIONS:

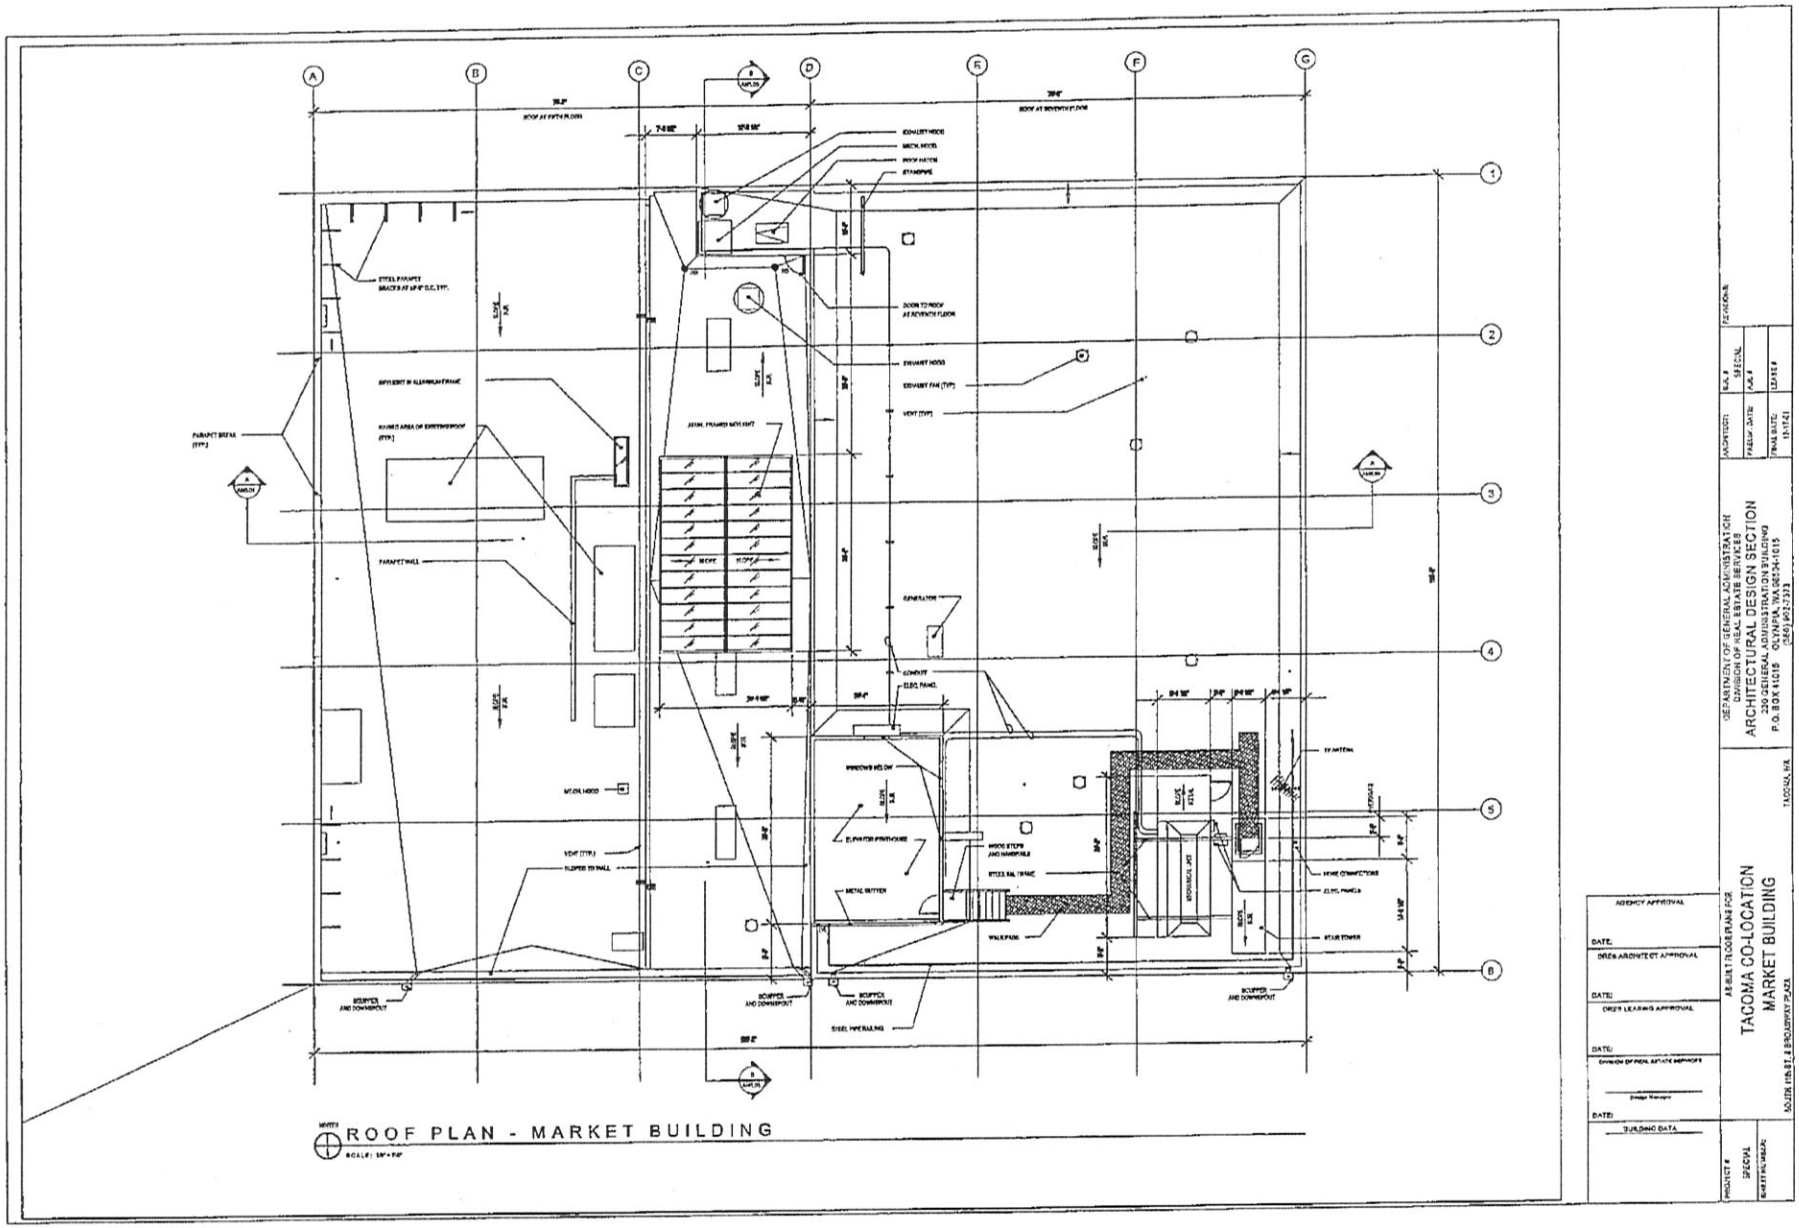
ROOF PLAN - MARKET BUILDING
DEPARTMENT OF GENERAL ADMINISTRATION
DIVISION OF REAL ESTATE SERVICES
ARCHITECTURAL DESIGN SECTION
230 GENERAL ADMINISTRATION BUILDING
P.O. BOX 41015 OLYMPIA, WA 98504-1015
(360) 902-7373
ARBUILT FLOOR PLANS FOR
TACOMA CO-LOCATION
MARKET BUILDING
SOUTH 11th ST. & BROADWAY PLAZA
TACOMA, WA
AGENCY APPROVAL
DATE:
DRES ARCHITECT APPROVAL
DATE:
DRES LEASING APPROVAL
DATE:
DIVISION OF REAL ESTATE SERVICES
DATE:
BUILDING DATA
PROJECT #
SPECIAL
SHEET NUMBER:
REVISIONS:
ARCHITECT:
PARKER DATE:
FINAL DATE:
11-17-21
S.A. #
SPECIAL
A.R. #
LEASE #

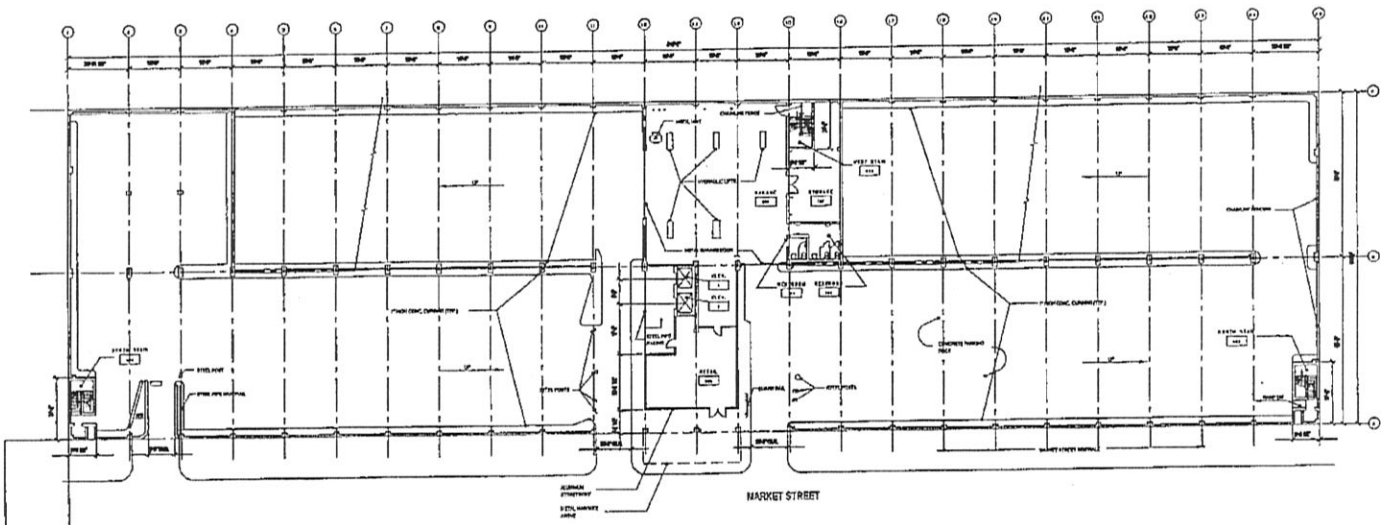

FIRST LEVEL PLAN - PARKING STRUCTURE

TACOMA CO-LOCATION
TACOMA, WASHINGTON
PARKING STRUCTURE
FIRST LEVEL PLAN

GRAHAM PARTNERSHIP

AP2.01